

STATE ENGINEER  
Salem, Oregon

Linn  
14674

# Well Record


STATE WELL NO. 12/2W-24C  
COUNTY LINN  
APPLICATION NO. GR-2617

OWNER: Mrs. M. A. Richmond  
MAILING ADDRESS: Rt. 3, Box 189

LOCATION OF WELL: Owner's No. \_\_\_\_\_  
CITY AND STATE: DeMoines, Iowa

NE 1/4 NW 1/4 Sec. 24 T. 12 S., R. 2 W., W.M.

Bearing and distance from section or subdivision  
corner 1188' S. and 1452' E.

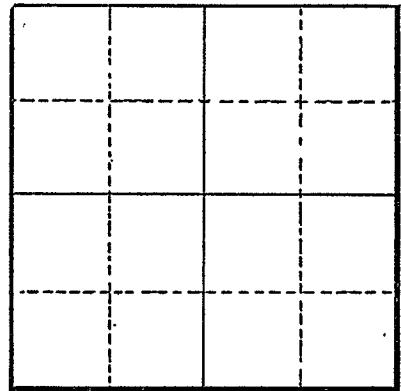

Section

Altitude at well \_\_\_\_\_

TYPE OF WELL: Drilled Date Constructed 1952

Depth drilled 19 Depth cased 19

### CASING RECORD:

10-inch

### FINISH:

Slot perforations from 0' to 19'

### AQUIFERS:

### WATER LEVEL:

9-feet

PUMPING EQUIPMENT: Type Westinghouse Centrifugal H.P. 5  
Capacity 120 G.P.M.

### WELL TESTS:

Drawdown \_\_\_\_\_ ft. after \_\_\_\_\_ hours \_\_\_\_\_ G.P.M.  
Drawdown \_\_\_\_\_ ft. after \_\_\_\_\_ hours \_\_\_\_\_ G.P.M.

USE OF WATER Irrigation Temp. \_\_\_\_\_ °F., 19

SOURCE OF INFORMATION GR-2484

DRILLER or DIGGER Alford Rucker, Lebanon, Oregon

### ADDITIONAL DATA:

Log \_\_\_\_\_ Water Level Measurements \_\_\_\_\_ Chemical Analysis \_\_\_\_\_ Aquifer Test \_\_\_\_\_

### REMARKS: