

STATE ENGINEER  
Salem, Oregon

LINN  
2676

# Well Record

STATE WELL NO. 9/LW-13C  
COUNTY Linn  
APPLICATION NO. GR-3502

OWNER: City Water Department

MAILING ADDRESS: Box 190


LOCATION OF WELL: Infiltration Gallery #1  
Owner's No.

CITY AND STATE: Salem, Oregon

NE 1/4 NW 1/4 Sec. 13 T. 9 N. S. R. 1 E. W., W.M.

Bearing and distance from section or subdivision

corner 1060' S. and 1375' E.

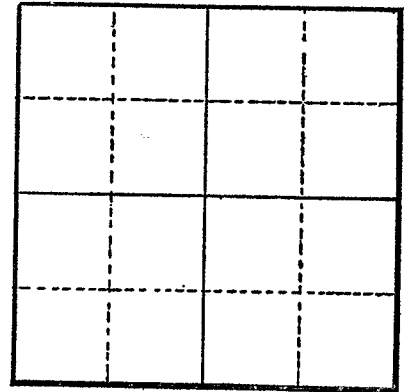

Section

Altitude at well

TYPE OF WELL: Date Constructed 1937

Depth drilled Depth cased

CASING RECORD:

FINISH:

AQUIFERS:

WATER LEVEL:

PUMPING EQUIPMENT: Type Capacity G.P.M. H.P.

WELL TESTS:  
Drawdown ft. after hours G.P.M.  
Drawdown ft. after hours G.P.M.

USE OF WATER Municipal Water Supply Temp. °F., 19  
SOURCE OF INFORMATION GR-3223

DRILLER or DIGGER

ADDITIONAL DATA:

Log Water Level Measurements Chemical Analysis Aquifer Test

REMARKS: