

STATE ENGINEER
Salem, Oregon

LINN
2677

Well Record

STATE WELL NO. 9/1W-13D
COUNTY Linn
APPLICATION NO. GR-3509

OWNER: City Water Department


MAILING ADDRESS: Salem

LOCATION OF WELL: Owner's No. 11

CITY AND STATE: Oregon

NW 1/4 NW 1/4 Sec. 13 T. 9 N. S., R. 1 E. W., W.M.

Bearing and distance from section or subdivision corner 860' S. and 660' E.

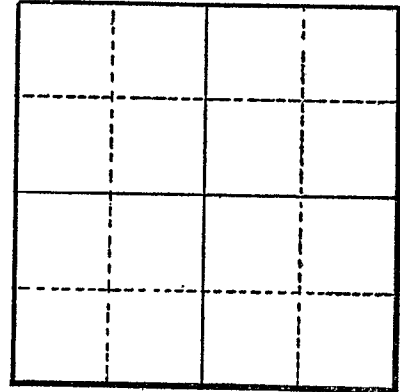

Section

Altitude at well

TYPE OF WELL: drilled Date Constructed 1940

Depth drilled 60' Depth cased

CASING RECORD:

FINISH:

8" strainer welded to suction

AQUIFERS:

WATER LEVEL:

12'

PUMPING EQUIPMENT: Type Sterling, vertical turbine 10" H.P. 10
Capacity 1100 G.P.M.

WELL TESTS:

Drawdown ft. after hours pumping 1100 G.P.M.
Drawdown ft. after hours G.P.M.

USE OF WATER Municipal Water Supply Temp. °F. 19

SOURCE OF INFORMATION GR-3229

DRILLER or DIGGER

ADDITIONAL DATA:

Log Water Level Measurements Chemical Analysis Aquifer Test

REMARKS: