

STATE ENGINEER
Salem, Oregon

LINN
2678

Well Record

STATE WELL NO. 9/lw-13D
COUNTY Linn
APPLICATION NO. GR-3510

OWNER: City Water Department


MAILING ADDRESS: Salem

LOCATION OF WELL: Owner's No. 9

CITY AND STATE: Oregon

NW 1/4 NW 1/4 Sec. 13 T. 9 N. 1 E. S., R. 1 W., W.M.

Bearing and distance from section or subdivision corner 800' S. and 450' E.

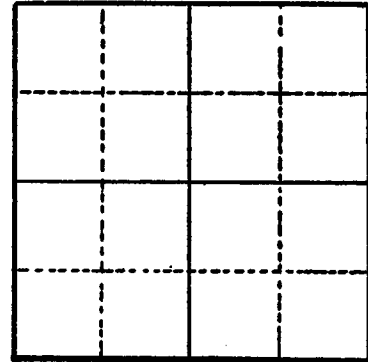

Section

Altitude at well

TYPE OF WELL: drilled. Date Constructed 1939

Depth drilled 60' Depth cased 60'

CASING RECORD:

16"

FINISH:

perforated with star perforator at water bearing stratas

AQUIFERS:

gravel, sand

WATER LEVEL:

12'

PUMPING EQUIPMENT: Type Sterling Vertical Turbine 12" H.P. 15
Capacity 1775 G.P.M.

WELL TESTS:

Drawdown ft. after hours pumping 1775 G.P.M.
Drawdown ft. after hours G.P.M.

USE OF WATER Municipal Water Supply Temp. °F. 19

SOURCE OF INFORMATION GR-3230

DRILLER or DIGGER R. J. Strasser Drilling Co.

ADDITIONAL DATA:

Log Water Level Measurements Chemical Analysis Aquifer Test

REMARKS:

loose gravel and sand	6	6
tight cemented gravel	10	16
loose gravel - water bearing	3	19
cemented gravel	7	26
loose gravel - water bearing	2	28
fairly loose dirty gravel	7	35
cemented gravel and boulders	25	60