

STATE ENGINEER
Salem, Oregon

Linn
2741

Well Record

STATE WELL NO. 9/1W-15R(1)
COUNTY Linn
APPLICATION NO. GR-220

OWNER: Carl Bethel

MAILING ADDRESS:


LOCATION OF WELL: Owner's No. 1

CITY AND STATE: Stayton, Oregon

SE 1/4 SE 1/4 Sec. 15 T. 9 N. S., R. 1 E. W., W.M.

Bearing and distance from section or subdivision

corner 300 ft. E. & 1 ft. S. from NW cor. SE 1/4 SE 1/4

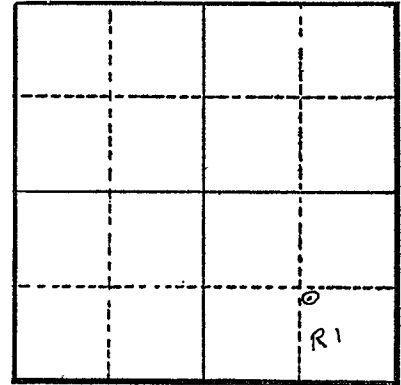

Section 15

Altitude at well 430 ft. Interpolated

TYPE OF WELL: drilled Date Constructed 5/3/54

Depth drilled 26 Depth cased 26

CASING RECORD: 10 - inch casing set from 0 to 26 ft.

FINISH: Perforations set from 17 to 26 ft.

AQUIFERS: unknown

WATER LEVEL:

PUMPING EQUIPMENT: Type Cornell H.P. 20
Capacity 300 G.P.M.

WELL TESTS:

Drawdown ft. after hours G.P.M.

Drawdown ft. after hours G.P.M.

USE OF WATER Irrigation 15 acres Temp. °F., 19

SOURCE OF INFORMATION Reg. St. GR-220

DRILLER or DIGGER

ADDITIONAL DATA:

Log Water Level Measurements Chemical Analysis Aquifer Test

REMARKS: