

STATE ENGINEER
Salem, Oregon

Linn
2743

Well Record

STATE WELL NO. 9/1W-15P
COUNTY Linn
APPLICATION NO. GR-1750

GR- 1697

OWNER: Edd Hobson


MAILING ADDRESS:

LOCATION OF WELL: Owner's No. #1

CITY AND STATE: Stayton, Oregon

SE 1/4 SW 1/4 Sec. 15 T. 9 S., R. 1 W., W.M.

Bearing and distance from section or subdivision corner 450' W. & 250' N. from S¹/₄ cor. Sec. 15

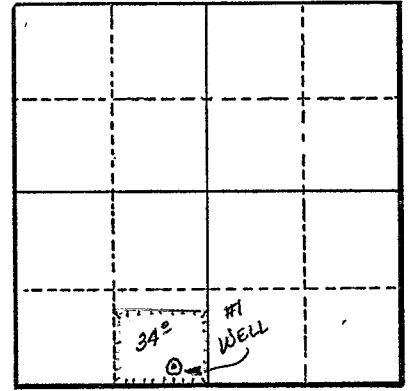

Section 15

Altitude at well

TYPE OF WELL: Drilled Date Constructed 1954

Depth drilled 18' Depth cased 18'

CASING RECORD:
8"

FINISH:
Perforated from 6 to 18 ft.

AQUIFERS:

WATER LEVEL:
12'

PUMPING EQUIPMENT: Type Cent. H.P. 10
Capacity 340 G.P.M.

WELL TESTS:
Drawdown 15 ft. after 300 hours G.P.M.
Drawdown ft. after hours G.P.M.

USE OF WATER Irrigation Temp. °F., 19

SOURCE OF INFORMATION GR Record

DRILLER or DIGGER

ADDITIONAL DATA:
Log N.A. Water Level Measurements Chemical Analysis Aquifer Test

REMARKS:
Irrigation of 3/4 acres.