

STATE ENGINEER
Salem, Oregon

Lin'n
2744

Well Record

GR- 1698

STATE WELL NO. 9/1W-15P
COUNTY Linn
APPLICATION NO. GR- 1751

OWNER: Edd Hobson


MAILING ADDRESS: _____

LOCATION OF WELL: Owner's No. #2

CITY AND STATE: Stayton, Oregon

SE 1/4 SW 1/4 Sec. 15 T. 9 S., R. 1 W., W.M.

Bearing and distance from section or subdivision corner 700' W. & 300' N. from S¹/₄ cor. Sec. 15

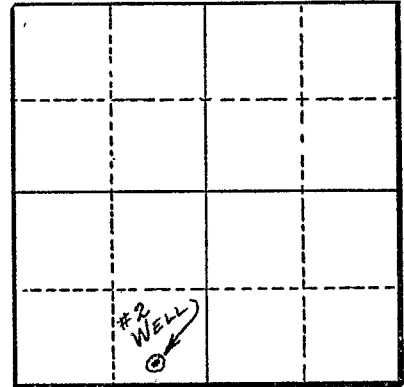

Altitude at well _____

TYPE OF WELL: Drilled Date Constructed 1954

Depth drilled 18' Depth cased 18'

Section 15

CASING RECORD:
8"

FINISH:

Perforated from 6 to 18 ft.

AQUIFERS:

WATER LEVEL:

12'

PUMPING EQUIPMENT: Type Cent. H.P. 10
Capacity 300 G.P.M.

WELL TESTS:

Drawdown 15 ft. after _____ hours 300 G.P.M.
Drawdown _____ ft. after _____ hours _____ G.P.M.

USE OF WATER Irrigation Temp. _____ °F., 19 _____

SOURCE OF INFORMATION GR Record

DRILLER or DIGGER _____

ADDITIONAL DATA:

Log N.A. Water Level Measurements _____ Chemical Analysis _____ Aquifer Test _____

REMARKS:

Irrigation of 34 acres.