

STATE ENGINEER
Salem, Oregon

Levin
3010

Well Record

STATE WELL NO. 9/1W - 29K
COUNTY LINN
APPLICATION NO. GR-2122

OWNER: Floyd E. Becker


MAILING ADDRESS: RT. 2, Box 249

LOCATION OF WELL: Owner's No. _____

CITY AND STATE: Scio, Oregon

NW $\frac{1}{4}$ SE $\frac{1}{4}$ Sec. 29 T. 9 N. S., R. 1 E. W., W.M.

Bearing and distance from section or subdivision corner 1914' N. and 2013' W.

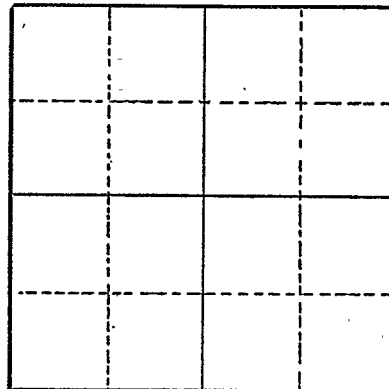

Section

Altitude at well

TYPE OF WELL: Drilled Date Constructed 1954

Depth drilled 128 Depth cased 80

CASING RECORD:

8-inch

FINISH:

Perforation from 5 to 80

AQUIFERS:

Sand and gravel

WATER LEVEL:

3-feet

PUMPING EQUIPMENT: Type Fairbanks Morse Turbine H.P. 7 $\frac{1}{2}$
Capacity 250 G.P.M.

WELL TESTS:

Drawdown	<u>62</u>	ft. after	_____	hours	_____	Pumping	<u>147</u>	G.P.M.
Drawdown	<u>110</u>	ft. after	_____	hours	_____	Pumping	<u>220</u>	G.P.M.

USE OF WATER Irrigation Temp. _____ °F. _____, 19____

SOURCE OF INFORMATION GR-2038

DRILLER or DIGGER Marion West, Salem, Oregon

ADDITIONAL DATA:

Log Water Level Measurements _____ Chemical Analysis _____ Aquifer Test _____

REMARKS:

