

STATE ENGINEER
Salem, Oregon

Linn
3/21

Well Record


STATE WELL NO. 9/2W-36A
COUNTY Linn
~~APPLICATION NO.~~ GR-2805

OWNER: G. E. Lynch
MAILING ADDRESS: Route 2

LOCATION OF WELL: Owner's No. _____
CITY AND STATE: Scio, Oregon

NE 1/4 NE 1/4 Sec. 36 T. 9 N. S. R. 2 E. W. W.M.

Bearing and distance from section or subdivision
corner S. 28° 20' W. 7.5 chains

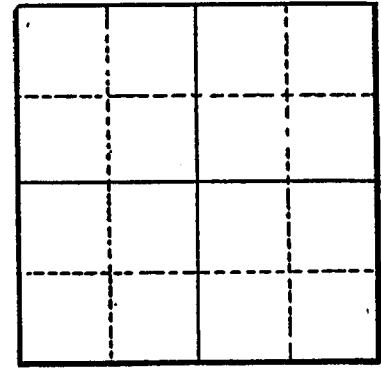

Altitude at well _____

TYPE OF WELL: drilled Date Constructed 1952

Depth drilled 125 Depth cased 95

Section _____

CASING RECORD:

6-inch

FINISH: Slot perforations from 32 to 40
slot perforations from 44 to 51
slot perforations from 60 to 74
slot perforations from 74 to 92

AQUIFERS:

Clay, gravel, boulders and sand

WATER LEVEL:
20-feet

PUMPING EQUIPMENT: Type Fairbanks Morse Turbine H.P. 5
Capacity 70 G.P.M.

WELL TESTS:
Drawdown 20 ft. after _____ hours Pumping 125 G.P.M.
Drawdown _____ ft. after _____ hours _____ G.P.M.

USE OF WATER irrigation Temp. °F. _____, 19

SOURCE OF INFORMATION GR-2697
DRILLER or DIGGER Shafer and Gallatly, Box 847, Philomath, Oregon

ADDITIONAL DATA:
Log Water Level Measurements _____ Chemical Analysis _____ Aquifer Test _____

REMARKS:	Clay and coarse gravel	20	20
	Boulders	10	30
	coarse gravel and boulders	16	46
	gravel and clay	24	70
	gravel and sand brown	4	74
	sand brown	8	82