

STATE ENGINEER
Salem, Oregon

Linn
3152

Well Record

STATE WELL NO. 9/3W-3LE(1)
COUNTY Linn
APPLICATION NO. GR-800

OWNER: Glen H. Wilfert


MAILING ADDRESS: 803 W. 5th

LOCATION OF WELL: Owner's No. 1

CITY AND STATE: Albany, Oregon

SW $\frac{1}{4}$ NW $\frac{1}{4}$ Sec. 31 T. 9 S., R. 3 W., W.M.

Bearing and distance from section or subdivision corner Beginning at NW cor. Sec. 31 thence S. 27 chs. thence E. 12 chs.

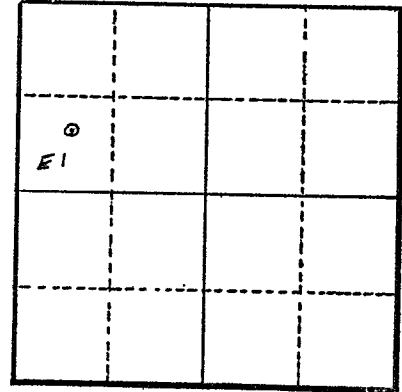

Section 31

Altitude at well 175 ft.

TYPE OF WELL: drilled Date Constructed 1947

Depth drilled 30 ft. Depth cased 30 ft.

CASING RECORD: 12 inch

FINISH: Perforated 15 to 30 ft.

AQUIFERS:

WATER LEVEL: 10 ft.

PUMPING EQUIPMENT: Type Cornell centrifugal H.P. 15
Capacity 500 G.P.M.

WELL TESTS:
Drawdown 1 ft. after 500 hours G.P.M.
Drawdown 3 ft. after 1000 hours G.P.M.

USE OF WATER irrigation Temp. °F. 19

SOURCE OF INFORMATION GR-800

DRILLER or DIGGER

ADDITIONAL DATA:

Log X Water Level Measurements Chemical Analysis Aquifer Test

REMARKS: Log: Silt 0 to 12 ft.
Gravel 12 to 30 ft.