

STATE ENGINEER  
Salem, Oregon

Linn  
3153

# Well Record

STATE WELL NO. 9/3W-31M(1)  
COUNTY Linn  
APPLICATION NO. GR-801

OWNER: Glen H. Wilfert

MAILING ADDRESS:

803 W. 5th

LOCATION OF WELL: Owner's No. 2


CITY AND STATE:

Albany, Oregon

NW 1/4 SW 1/4 Sec. 31 T. 9 S., R. 3 W., W.M.

Bearing and distance from section or subdivision

corner Beginning at the SW cor. Sec. 31 thence  
N. 33 chs. E. 15 chs.

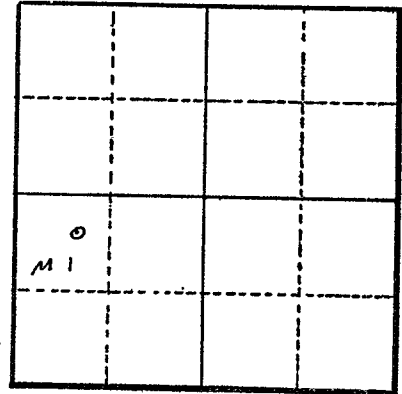

Section 31

Altitude at well 175 ft.

TYPE OF WELL: drilled Date Constructed 1951

Depth drilled 30 ft. Depth cased 30 ft.

CASING RECORD: 10 inch

FINISH: Perforated 15 to 30 ft.

AQUIFERS:

WATER LEVEL: 10 ft.

PUMPING EQUIPMENT: Type Fairbanks Morse centrifugal pump H.P. 10, 15 & 25  
Capacity 800 G.P.M.

WELL TESTS:

Drawdown 2 ft. after        hours 800 G.P.M.

Drawdown 3 ft. after        hours 1000 G.P.M.

USE OF WATER irrigation Temp.        °F., 19

SOURCE OF INFORMATION GR-801

DRILLER or DIGGER Hamilton

ADDITIONAL DATA:

Log X Water Level Measurements        Chemical Analysis        Aquifer Test       

REMARKS: Log: Silt 0 to 12 ft.  
Gravel 12 to 30 ft.