

STATE ENGINEER
Salem, Oregon

Linn
3154

Well Record

GR- 1526

STATE WELL NO. 9/3W-31N
COUNTY Linn
APPLICATION NO. GR- 1505

OWNER: N. L. Grate

MAILING

ADDRESS: Rt. 2, Box 356

LOCATION OF WELL: Owner's No. #2


CITY AND

STATE: Albany, Oregon

SW 1/4 SW 1/4 Sec. 31 T. 9 S., R. 3 W., W.M.

Bearing and distance from section or subdivision

corner N. 62°25'E. 17.75 ch. from SW cor. Sec. 31

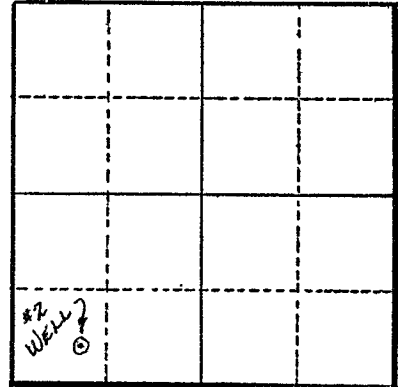

Section 31

Altitude at well 175'

TYPE OF WELL: Drilled Date Constructed 1944

Depth drilled 28' Depth cased 28'

CASING RECORD:

10"

FINISH:

Slot perforations from 25 to 28 ft.

AQUIFERS:

WATER LEVEL:

12'

PUMPING EQUIPMENT: Type 3" Cent. H.P. 30
Capacity 400 G.P.M.

WELL TESTS:

Drawdown _____ ft. after _____ hours _____ G.P.M.

Drawdown _____ ft. after _____ hours _____ G.P.M.

USE OF WATER Irrigation Temp. _____ °F., 19

SOURCE OF INFORMATION GR Record

DRILLER or DIGGER Bill Hamilton Drilling Co.

ADDITIONAL DATA:

Log N.A. Water Level Measurements _____ Chemical Analysis _____ Aquifer Test _____

REMARKS:

Irrigation of 42.8 acres.