

STATE ENGINEER  
Salem, Oregon

Linn  
3157

# Well Record

STATE WELL NO. 9/3W-31R(1)  
COUNTY Linn  
APPLICATION NO. GR-773

OWNER: Ardle Edwards


MAILING ADDRESS: Rt. 2, Box 350

LOCATION OF WELL: Owner's No. 2

CITY AND STATE: Albany, Oregon

SE 1/4 SE 1/4 Sec. 31 T. 9 S., R. 3 W., W.M.

Bearing and distance from section or subdivision  
corner 300' N. of SE cor. Sec. 31

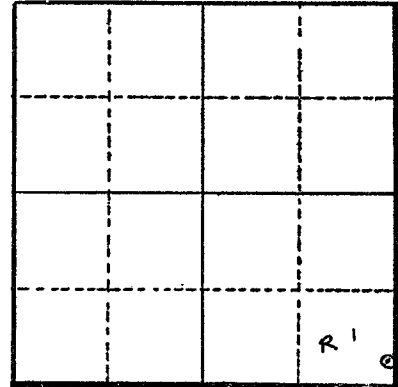

Section 31

Altitude at well 187 ft. Interpolated

TYPE OF WELL: drilled Date Constructed 4/1/50

Depth drilled 26 ft. Depth cased 26 ft.

CASING RECORD: 10 inch

FINISH:

AQUIFERS:

WATER LEVEL: 13 ft.

PUMPING EQUIPMENT: Type F. M. electric H.P. 20  
Capacity G.P.M.

WELL TESTS:  
Drawdown ft. after hours G.P.M.  
Drawdown ft. after hours G.P.M.

USE OF WATER Irrigation Temp. °F., 19

SOURCE OF INFORMATION GR-773

DRILLER or DIGGER

ADDITIONAL DATA:

Log  Water Level Measurements Chemical Analysis Aquifer Test

REMARKS: