

STATE ENGINEER  
Salem, Oregon

Linn  
3158

# Well Record

STATE WELL NO. 9/3W-32C(1)  
COUNTY Linn  
APPLICATION NO. GR-500

OWNER: E. B. & Constance Henningsen

MAILING ADDRESS: Rt. 1

LOCATION OF WELL: Owner's No. 2


CITY AND STATE: Jefferson

NE 1/4 NW 1/4 Sec. 32 T. 9 N. S., R. 3 W. W.M.

Bearing and distance from section or subdivision

corner S. 39° 25' W. 58.75 chs. from NW cor.

DLC 56

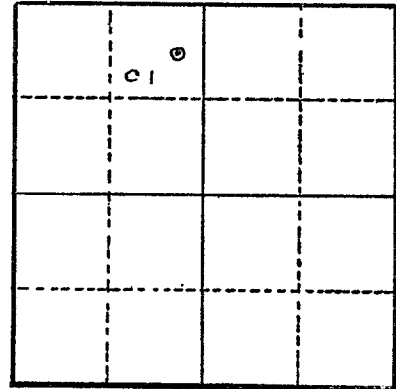

Section 32

Altitude at well 190 ft. Interpolated

TYPE OF WELL: dug Date Constructed 1934

Depth drilled 22 ft. Depth cased 22 ft.

CASING RECORD: 12 - inch steel casing set from 0 to 22 ft.

FINISH: open end

AQUIFERS: gravel from 6 to 22 ft.

WATER LEVEL: 10 ft. below land surface

PUMPING EQUIPMENT: Type centrifugal H.P. 20  
Capacity 350 G.P.M.

WELL TESTS:  
Drawdown 1 1/2 ft. after \_\_\_\_\_ hours pumping 350 G.P.M.  
Drawdown \_\_\_\_\_ ft. after \_\_\_\_\_ hours \_\_\_\_\_ G.P.M.

USE OF WATER Irrigation 38 acres Temp. \_\_\_\_\_ °F. \_\_\_\_\_, 19\_\_\_\_

SOURCE OF INFORMATION Reg. St. GR-500

DRILLER or DIGGER \_\_\_\_\_

ADDITIONAL DATA:

Log  Water Level Measurements \_\_\_\_\_ Chemical Analysis \_\_\_\_\_ Aquifer Test \_\_\_\_\_

REMARKS: Log: Topsoil 0 to 6 ft.  
Gravel 6 to 22 ft.