

STATE ENGINEER
Salem, Oregon

Linn
3159

Well Record

STATE WELL NO. 9/3W-32F(1)
COUNTY Linn
APPLICATION NO. GR-500

OWNER: E. B. & Constance Henningsen

MAILING ADDRESS: Rt. 1


LOCATION OF WELL: Owner's No. 3

CITY AND STATE: Jefferson, Oregon

SW 1/4 NE 1/4 Sec. 32 T. 9 S., R. 3 E., W.M.

Bearing and distance from section or subdivision

corner S. 27° W. 73.5 chs. from NW cor. DLG 56

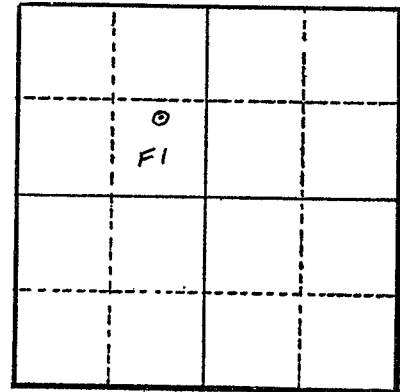

Section 32

Altitude at well 190 ft. Interpolated

TYPE OF WELL: dug Date Constructed 1934

Depth drilled 22 ft. Depth cased 22 ft.

CASING RECORD: 12 - inch steel casing set from 0 to 22 ft.

FINISH: Open end casing

AQUIFERS: Gravel from 6 to 22 ft.

WATER LEVEL: 10 ft. below land surface

PUMPING EQUIPMENT: Type centrifugal H.P. 20
Capacity 350 G.P.M.

WELL TESTS:
Drawdown 1 1/2 ft. after pumping 350 G.P.M.
Drawdown ft. after hours G.P.M.

USE OF WATER Irrigation 38 acres Temp. °F. 19

SOURCE OF INFORMATION Reg. St. GR-500

DRILLER or DIGGER

ADDITIONAL DATA:

Log ^X Water Level Measurements Chemical Analysis Aquifer Test

REMARKS: Log: Topsoil 0 to 6 ft.
Gravel 6 to 22 ft.