

STATE ENGINEER
Salem, Oregon

Linn
316

Well Record

STATE WELL NO. 9/3W-32N(1)
COUNTY Linn
APPLICATION NO. GR-774

OWNER: Ardle Edwards


MAILING ADDRESS: Rt. 2, Box 350

LOCATION OF WELL: Owner's No. 3

CITY AND STATE: Albany, Oregon

SW 1/4 SW 1/4 Sec. 32 T. 9 N. S, R. 3 E. W., W.M.

Bearing and distance from section or subdivision corner 400' N. & 400' E. of SW cor. Sec. 32

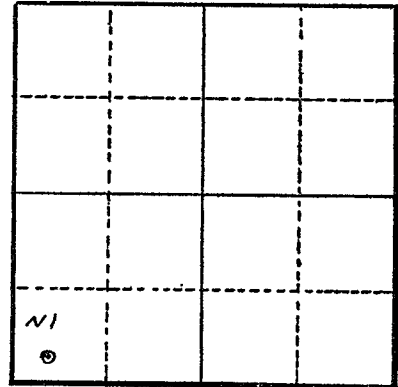

Altitude at well 187 ft. Interpolated

TYPE OF WELL: drilled Date Constructed April, 1955

Depth drilled 26 ft. Depth cased 26 ft.

Section 32

CASING RECORD: 10 inch

FINISH:

AQUIFERS:

WATER LEVEL: 13 ft.

PUMPING EQUIPMENT: Type Fairbanks Morse electric H.P. 10
Capacity G.P.M.

WELL TESTS:

Drawdown ft. after hours G.P.M.

Drawdown ft. after hours G.P.M.

USE OF WATER irrigation Temp. °F. 19

SOURCE OF INFORMATION GR-774

DRILLER or DIGGER Hamilton Drilling Co., Albany

ADDITIONAL DATA:

Log Water Level Measurements Chemical Analysis Aquifer Test

REMARKS: Log: Sandy loam 0 to 5 ft.
Sand & gravel ?
(This location of land has spots of gravel)