

STATE ENGINEER
Salem, Oregon

6100
3162

Well Record

STATE WELL NO. 9/3W-32R
COUNTY Linn
APPLICATION NO. GR-1663

GR- 1614

OWNER: J. P. Grizzel


MAILING ADDRESS: Rt. 2, Box 361

LOCATION OF WELL: Owner's No. #2

CITY AND STATE: Albany, Oregon

SE 1/4 SE 1/4 Sec. 32 T. 9 S., R. 3 W., W.M.

Bearing and distance from section or subdivision corner 11.75 ch. N. 54° 15' W. from SE cor. Sec. 32.

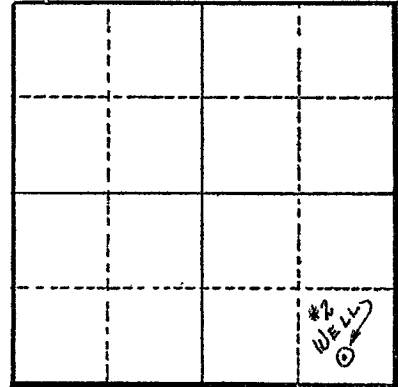

Section 32

Altitude at well 190'

TYPE OF WELL: Drilled Date Constructed 1952

Depth drilled 20' Depth cased 20'

CASING RECORD:

10"

FINISH:

Slot perforations from 10 to 20 ft.

AQUIFERS:

WATER LEVEL:

10'

PUMPING EQUIPMENT: Type F. M. 2" Cent. H.P. 10
Capacity 200 G.P.M.

WELL TESTS:

Drawdown ft. after hours G.P.M.
Drawdown ft. after hours G.P.M.

USE OF WATER Irrigation Temp. °F., 19

SOURCE OF INFORMATION GR Record

DRILLER or DIGGER Bill Hamilton

ADDITIONAL DATA:

Log N.A. Water Level Measurements Chemical Analysis Aquifer Test

REMARKS:

Irrigation of 25 acres.