

STATE ENGINEER
Salem, Oregon

Well Record

STATE WELL NO. 9/2/20R
COUNTY LINN
APPLICATION NO. GR-3479

*Linn
3355*

OWNER: Simpson Redwood Co. dba Simpson Logging Co.


MAILING ADDRESS: 2301 N. Columbia Blvd.

LOCATION OF WELL: Owner's No. Well #2

CITY AND STATE: Portland, Oregon

SE 1/4 SE 1/4 Sec. 20 T. 9 ~~N.~~ S., R. 2 ~~E.~~ W., W.M.

Bearing and distance from section or subdivision corner 430' N. and 655' W.

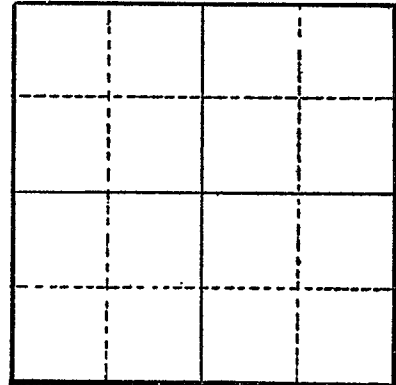

Section

Altitude at well

TYPE OF WELL: drilled Date Constructed 1951

Depth drilled 119' Depth cased 34.5'

CASING RECORD:

6"

FINISH:

AQUIFERS:

clay, boulders, sand rock, shale

WATER LEVEL:

12'

PUMPING EQUIPMENT: Type Layne & Bowler turbine H.P. 3
Capacity 20 G.P.M.

WELL TESTS:

Drawdown ft. after hours G.P.M.
Drawdown ft. after hours G.P.M.

USE OF WATER Industrial Temp. °F., 19.....

SOURCE OF INFORMATION GR-3213

DRILLER or DIGGER

ADDITIONAL DATA:

Log Water Level Measurements Chemical Analysis Aquifer Test

REMARKS:

clay	7	7
boulders	23	30
yellow sand rock	6	36
gray sand rock	13	49
blue shale	4	53
black sand rock	12	65
blue shale	54	119