

Linn  
3356

# Well Record

OWNER: Simpson Redwood Co. dba Simpson Logging Co.


MAILING ADDRESS: 2301 N. Columbia Blvd.

LOCATION OF WELL: Owner's No. Well #1

CITY AND STATE: Portland, Oregon

SE 1/4 SE 1/4 Sec. 20 T. 9 N. S., R. 2 E. W.M.

Bearing and distance from section or subdivision corner 920' N. and 1200' W.

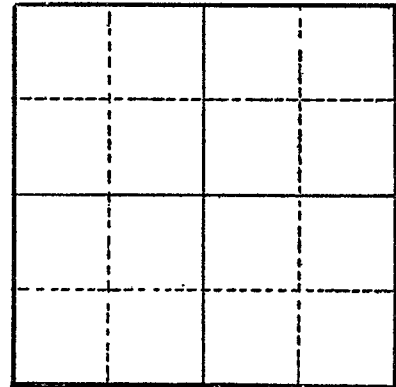

Section

Altitude at well

TYPE OF WELL: drilled Date Constructed 1951

Depth drilled 453' Depth cased

### CASING RECORD:

### FINISH:

### AQUIFERS:

gravel, rock, shale, sandstone

### WATER LEVEL:

12'

PUMPING EQUIPMENT: Type "Pacific" Turbine

H.P. 7 1/2

Capacity 25 G.P.M.

### WELL TESTS:

Drawdown ft. after hours G.P.M.

Drawdown ft. after hours G.P.M.

USE OF WATER Industrial Temp. °F., 19

SOURCE OF INFORMATION GR-3212

DRILLER or DIGGER

### ADDITIONAL DATA:

Log  Water Level Measurements Chemical Analysis Aquifer Test

### REMARKS:


no record	69	69
gravel	8	77
broken rock	8	85
broken rock and shale	83	168
sandstone	7	175
blue shale	278	453

OWNER: Simpson Redwood Co. dba Simpson Logging Co. MAILING ADDRESS: 2301 N. Columbia Blvd.

LOCATION OF WELL: Owner's No. #1 CITY AND STATE: Portland, Oregon

SE 1/4 SE 1/4 Sec. 20 T. 9 S., R. 2 N. E. W.M.

Bearing and distance from section or subdivision corner 920' N. and 1200' W.

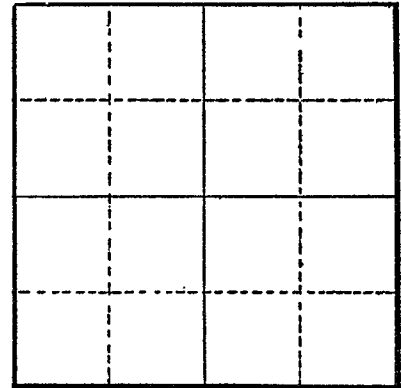

Section .....

Altitude at well .....

TYPE OF WELL: drilled Date Constructed 1951

Depth drilled 453 Depth cased .....

CASING RECORD:

FINISH:

AQUIFERS:

gravel, rock, shale and sandstone

WATER LEVEL:

12'

PUMPING EQUIPMENT: Type Pacific Turbine H.P. 7 1/2  
Capacity 25 G.P.M.

WELL TESTS:

Drawdown ..... ft. after ..... hours ..... G.P.M.  
Drawdown ..... ft. after ..... hours ..... G.P.M.

USE OF WATER industrial Temp. .... °F. ...., 19...

SOURCE OF INFORMATION GR-3212

DRILLER or DIGGER .....

ADDITIONAL DATA:

Log x Water Level Measurements ..... Chemical Analysis ..... Aquifer Test .....

REMARKS:

No record	69	69
gravel	8	77
broken rock	8	85
broken rock and shale	83	168
sandstone	7	175
blue shale	278	453