


Linn
3357

Well Record

OWNER: Simpson Redwood Company dba Simpson Logging Company
MAILING ADDRESS: 2301 N. Columbia Blvd.,
CITY AND STATE: Portland, Oregon

LOCATION OF WELL: Owner's No. #2
SE 1/4 SE 1/4 Sec. 20 T. 9 N S, R. 2 E W, W.M.
Bearing and distance from section or subdivision corner 430' N. and 655' W.

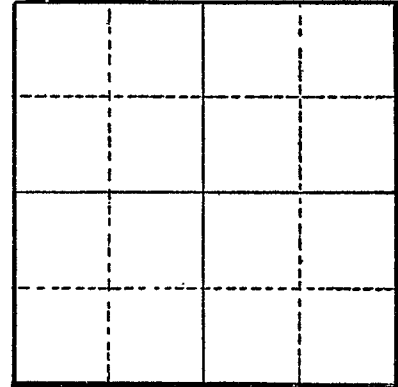

Section

Altitude at well

TYPE OF WELL: drilled Date Constructed 1951
Depth drilled 119 Depth cased 34.5

CASING RECORD:

6-inch

FINISH:

AQUIFERS:

Clay, boulders, rock and shale sand

WATER LEVEL:

12-feet

PUMPING EQUIPMENT: Type Layne & Bowler, Turbine H.P. 3
Capacity 20 G.P.M.

WELL TESTS:

Drawdown ft. after hours G.P.M.
Drawdown ft. after hours G.P.M.

USE OF WATER industrial Temp. °F. , 19

SOURCE OF INFORMATION GR-3213

DRILLER or DIGGER

ADDITIONAL DATA:

Log Water Level Measurements Chemical Analysis Aquifer Test

REMARKS:

Clay	7	7
Boulders	23	30
yellow sand rock	6	36
gray sand rock	13	49
blue shale	4	53
black sand rock	12	65
blue shale	54	119