

STATE ENGINEER
Salem, Oregon

Well Record

STATE WELL NO. 9/2-28G
COUNTY Linn
APPLICATION NO. GR-3206

OWNER: Glenn Julian

MAILING
ADDRESS: Route 1

LOCATION OF WELL: Owner's No. 3416

CITY AND
STATE: Lyons, Oregon


SW $\frac{1}{4}$ NE $\frac{1}{4}$ Sec. 28 T. 9 N. S., R. 2 E. W.M.

Bearing and distance from section or subdivision
corner 1452 feet S. and 2442 feet W. of NE corner
of Sec. 28.

Altitude at well

TYPE OF WELL: Drilled Date Constructed 1951

Depth drilled 125 Depth cased 47

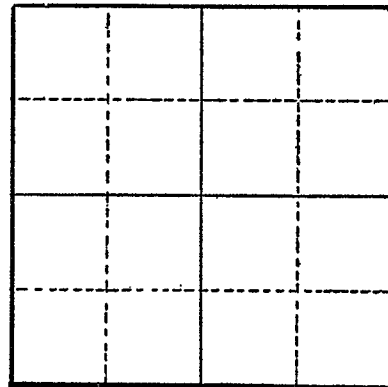

Section

CASING RECORD:

10-inch

FINISH:

Slotted perforations from 36 to 47

AQUIFERS:

WATER LEVEL:

36 feet

PUMPING EQUIPMENT: Type Advanced Berkeley Turbine H.P. 3½
Capacity G.P.M.

WELL TESTS:

Drawdown Unknown ft. after hours Pumping 50 G.P.M.

Drawdown ft. after hours G.P.M.

USE OF WATER Irrigation Temp. °F., 19.....

SOURCE OF INFORMATION GR-2983

DRILLER or DIGGER Chas. Evans, Salem, Oregon

ADDITIONAL DATA:

Log Water Level Measurements Chemical Analysis Aquifer Test

REMARKS: