

STATE ENGINEER
Salem, Oregon

Well Record

STATE WELL NO. 10/1W-4M
COUNTY LINN
APPLICATION NO. GR-2785

OWNER: Angus B. and Lucille M. Leffler

MAILING

ADDRESS: Rt. 1, Box 12

LOCATION OF WELL: Owner's No. _____

CITY AND

STATE: Scio, Oregon

NW 1/4 SW 1/4 Sec. 4 T. 10 N. S., R. 1 E. W., W.M.


Bearing and distance from section or subdivision

corner 1716' N. and 462' E.

Altitude at well _____

TYPE OF WELL: drilled Date Constructed 1941

Depth drilled 106 Depth cased 51

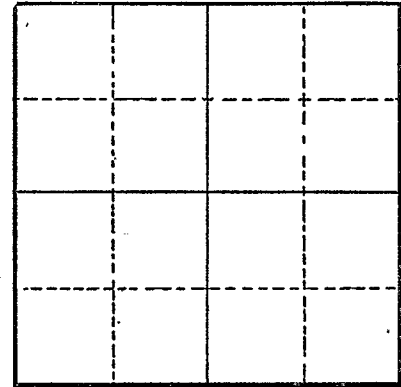

Section _____

CASING RECORD:

6-inch

FINISH:

Slot perforations from 45 to 51

AQUIFERS:

Rock, clay

WATER LEVEL:

20-feet

PUMPING EQUIPMENT: Type Jacuzzi Jet H.P. 2 1/2
Capacity 20 G.P.M.

WELL TESTS:

Drawdown _____ ft. after _____ hours _____ G.P.M.

Drawdown _____ ft. after _____ hours _____ G.P.M.

USE OF WATER irrigation Temp. _____ °F. _____, 19 _____

SOURCE OF INFORMATION GR-2632

DRILLER or DIGGER R. J. Strasser Drilling Co., Portland, Oregon

ADDITIONAL DATA:

Log X Water Level Measurements _____ Chemical Analysis _____ Aquifer Test _____

REMARKS:

Rock	10	10
Clay	18	28
Red rock	25	53
Blue rock	45	98
Honey comb rock	8	106