

STATE ENGINEER
Salem, Oregon

OBSERVATION WELL
Well Record

STATE WELL NO. 10/1W-5L
COUNTY Linn
APPLICATION NO. GR-1633

GR- 1598

OWNER: A. M. Hendrickson

MAILING

ADDRESS: P. O. Box 33

LOCATION OF WELL: Owner's No. #2


CITY AND

STATE: Scio, Oregon

NE $\frac{1}{4}$ SW $\frac{1}{4}$ Sec. 5 T. 10 S., R. 1 W., W.M.

Bearing and distance from section or subdivision

corner 2500' N. & 1800' E. from SW cor. Sec. 5

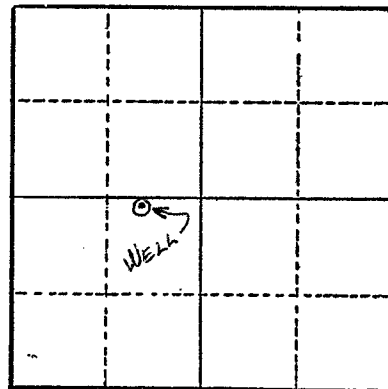

Section 5

Altitude at well

TYPE OF WELL: Drilled Date Constructed 1951

Depth drilled 225' Depth cased 110'

CASING RECORD:

10"

FINISH:

Torch cut perforations every 6 ft. from 0 to 110 ft.

AQUIFERS:

WATER LEVEL:

25'

PUMPING EQUIPMENT: Type Turbine H.P. 30
Capacity 650 G.P.M.

WELL TESTS:

Drawdown 138 ft. after hours 670 G.P.M.

Drawdown ft. after hours G.P.M.

USE OF WATER Irrigation Temp. °F. 19

SOURCE OF INFORMATION GR Record

DRILLER or DIGGER Studebaker

ADDITIONAL DATA:

Log Water Level Measurements Chemical Analysis Aquifer Test

REMARKS:

Log: Soil 0 to 4 ft.
Shale - hard 4 to 110 ft.
Rock 110 to 225 ft.
Gravel (water) 117 to 218 ft.

Irrigation of 70 acres.