

STATE ENGINEER
Salem, Oregon

417
3659

Well Record

STATE WELL NO. 10/1W-7Q
COUNTY LINN
APPLICATION NO. GR-2231

OWNER: Gus and Anna Leder


MAILING ADDRESS:

LOCATION OF WELL: Owner's No.

CITY AND STATE: Scio, Oregon

SW 1/4 SE 1/4 Sec. 7 T. 10 S., R. 1 W., W.M.

Bearing and distance from section or subdivision corner 1450' W and 175' N of SE corner

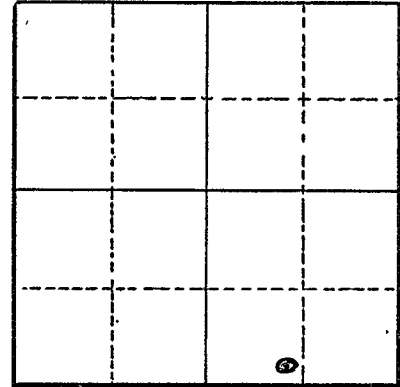

Section 7

Altitude at well

TYPE OF WELL: Drilled Date Constructed 1954

Depth drilled 20' Depth cased 20'

CASING RECORD:

8-inch

FINISH:

Perforated from 17' to 20'

AQUIFERS:

Sand and Gravel

WATER LEVEL:

4'

PUMPING EQUIPMENT: Type Pacific Pumping (General Electric Motor) H.P. 3

Capacity 75 G.P.M.

WELL TESTS:

Drawdown 8 ft. after 75 hours G.P.M.

Drawdown ft. after hours G.P.M.

USE OF WATER Irrigation Temp. °F., 19

SOURCE OF INFORMATION GR-3828

DRILLER or DIGGER Bill Long

ADDITIONAL DATA:

Log Water Level Measurements Chemical Analysis Aquifer Test

REMARKS:

Well was dug in 2 days, Sandy loam 9' deep - gravel 11'.