

STATE ENGINEER
Salem, Oregon

Linn LINN 4082
4082
51747
Well Record


STATE WELL NO. 10/2W-8J(1)
COUNTY Linn
APPLICATION NO. GR-248

OWNER: William Uppstad MAILING ADDRESS:

LOCATION OF WELL: Owner's No. 1 CITY AND STATE: Jefferson, Oregon

NE 1/4 SE 1/4 Sec. 8 T. 10 S., R. 2 W., W.M.

Bearing and distance from section or subdivision corner N. 24° W. 31.0 chs. from SE cor. Sec. 8

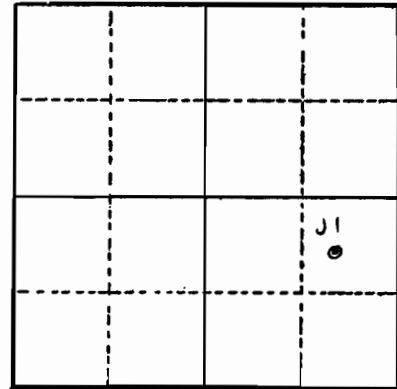

Section 8

Altitude at well 270 ft. Interpolated

TYPE OF WELL: driven Date Constructed 1941

Depth drilled 21 ft. Depth cased 21 ft.

CASING RECORD: 4 - inch casing (pipe) set from 0 to 21 ft.

FINISH: Dynamited following driving

AQUIFERS: unknown

WATER LEVEL: 10 ft. below land surface

PUMPING EQUIPMENT: Type 3" Fairbanks Morse centrifugal H.P. 15
Capacity 300 G.P.M.

WELL TESTS:
Drawdown 16 ft. after hours pumping 350 G.P.M.
Drawdown ft. after hours G.P.M.

USE OF WATER irrigation 40 acres Temp. °F., 19.....

SOURCE OF INFORMATION Reg. St. GR-236

DRILLER or DIGGER Charles Gee

ADDITIONAL DATA:
Log Water Level Measurements Chemical Analysis Aquifer Test

REMARKS: