

STATE ENGINEER
Salem, Oregon

Linn
4084
57749
LINN Well Record

STATE WELL NO. 10/2W-8N(1)
COUNTY Linn
APPLICATION NO. GR-248

OWNER: Wm. Upstad

MAILING ADDRESS:

LOCATION OF WELL: Owner's No. 3


CITY AND STATE:

Jefferson, Oregon

SW 1/4 SW 1/4 Sec. 8 T. 10 N. S., R. 2 W., W.M.

Bearing and distance from section or subdivision

corner N. 61° 30' E. 17.5 chs. from SW cor. Sec. 8

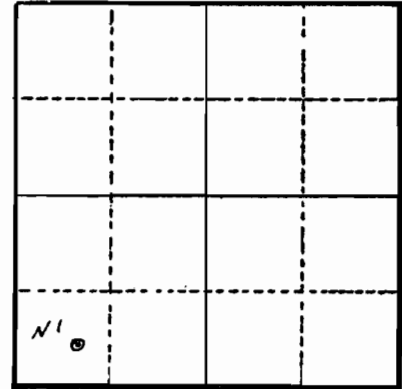

Section 8

Altitude at well 255 ft. Interpolated

TYPE OF WELL: drilled Date Constructed 4/26/55

Depth drilled 21 ft. Depth cased 21 ft.

CASING RECORD: 10-inch casing set from 0 to 21 ft.

FINISH: 1/2" x 3" slots (torch) set from 14 to 21 ft. at 3 in. intervals.

AQUIFERS: unknown

WATER LEVEL: 12 ft. below land surface

PUMPING EQUIPMENT: Type 2 1/2" Berkeley centrifugal H.P. 10
Capacity 250 G.P.M.

WELL TESTS:

Drawdown 19 ft. after hours pumping 450 G.P.M.
Drawdown ft. after hours G.P.M.

USE OF WATER Irrigation 30 acres Temp. °F., 19

SOURCE OF INFORMATION Reg. St. GR-248

DRILLER or DIGGER Bill Hamilton

ADDITIONAL DATA:

Log Water Level Measurements Chemical Analysis Aquifer Test

REMARKS:

