

STATE ENGINEER
Salem, Oregon

Linn 4088
5752
LINN-4088
Well Record

STATE WELL NO. 10/2W-8R(1)
COUNTY Linn
APPLICATION NO. GR-248

OWNER: William Uppstad


MAILING ADDRESS:

LOCATION OF WELL: Owner's No. 2

CITY AND STATE: Jefferson, Oregon

SE 1/4 SE 1/4 Sec. 8 T. 10 S., R. 2 W., W.M.

Bearing and distance from section or subdivision corner N. 56° 30' W. 15.75 chs. from SE cor. Sec. 8

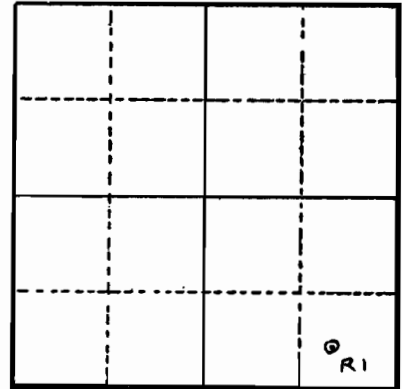

Section 8

Altitude at well 270 ft. Interpolated

TYPE OF WELL: driven Date Constructed 1941

Depth drilled 24 ft. Depth cased 24 ft.

CASING RECORD: 4 - inch pipe driven from 0 to 24 ft.

FINISH: Well dynamited following completion

AQUIFERS: unknown

WATER LEVEL: 24 ft. below land surface

PUMPING EQUIPMENT: Type 3" Pacific centrifugal H.P. 15
Capacity 400 G.P.M.

WELL TESTS:
Drawdown 16 ft. after hours pumping 450 G.P.M.
Drawdown ft. after hours G.P.M.

USE OF WATER irrigation 60 acres Temp. °F., 19.

SOURCE OF INFORMATION Reg. Statement GR-236

DRILLER or DIGGER Charles Gea

ADDITIONAL DATA:

Log Water Level Measurements Chemical Analysis Aquifer Test

REMARKS: