

STATE ENGINEER
Salem, Oregon

Linn
4156

Well Record

STATE WELL NO. 10/2W-15B(1)
COUNTY Linn
APPLICATION NO. GR-195

OWNER: Donald A. Bell


MAILING ADDRESS: Rt. 2, Box 116

LOCATION OF WELL: Owner's No. 1

CITY AND STATE: Scio, Oregon

NW 1/4 NE 1/4 Sec. 15 T. 10 N. S. R. 2 W., W.M.

Bearing and distance from section or subdivision corner S. 78° E. 9.0 chs. from NW cor. NE 1/4 Sec. 15

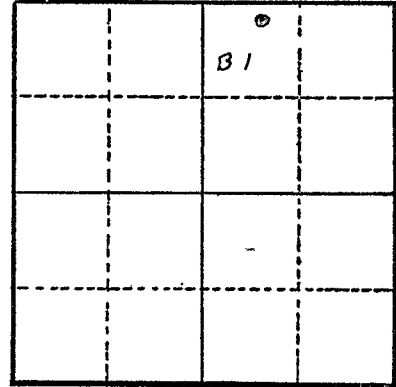

Altitude at well 290 ft. Interpolated

TYPE OF WELL: drilled Date Constructed 7/6/53

Depth drilled 71 ft. Depth cased 71 ft.

Section 15

CASING RECORD: 8 - inch steel casing set from 0 to 71 ft.

FINISH: not known

AQUIFERS: not known

WATER LEVEL: 15 ft. below land surface 7/15/53

PUMPING EQUIPMENT: Type Berkeley turbine H.P. 7 1/2
Capacity 250 G.P.M.

WELL TESTS:
Drawdown 35 ft. after _____ hours pumping 250 G.P.M.
Drawdown _____ ft. after _____ hours _____ G.P.M.

USE OF WATER Irrigation 25 acres Temp. _____ °F. 19

SOURCE OF INFORMATION Reg. St. GR-195

DRILLER or DIGGER Wm. Long; Rt. 3, Scio, Oregon

ADDITIONAL DATA:

Log _____ Water Level Measurements _____ Chemical Analysis _____ Aquifer Test _____

REMARKS: