

STATE ENGINEER
Salem, Oregon

Linn
4164

Well Record

G 5156
GR- 1000

STATE WELL NO. 10/2W-17N(2)
COUNTY Linn
APPLICATION NO. GR- 1035

OWNER: M.C. and/or Pearl Helms


MAILING ADDRESS: Rt. 1

LOCATION OF WELL: Owner's No. #12

CITY AND STATE: Jefferson, Oregon

SW 1/4 SW 1/4 Sec. 17 T. 10 S., R. 2 W., W.M.

Bearing and distance from section or subdivision corner N88°E. 17.5 ch. from SW cor. Sec. 17.

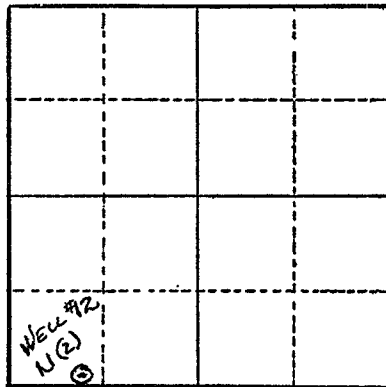

Section 17

Altitude at well 250 ft.

TYPE OF WELL: Drilled Date Constructed 1946

Depth drilled 31 ft. Depth cased

CASING RECORD:

8 inch

FINISH:

AQUIFERS:

WATER LEVEL:

8 ft.

PUMPING EQUIPMENT: Type Cornell 2 1/2" Cent. H.P. 20
Capacity 350 G.P.M.

WELL TESTS:

Drawdown 8 ft. after hours 650 G.P.M.

Drawdown ft. after hours G.P.M.

USE OF WATER Irrigation Temp. °F., 19

SOURCE OF INFORMATION G.R. Record

DRILLER or DIGGER Marion West

ADDITIONAL DATA:

Log N.A. Water Level Measurements Chemical Analysis Aquifer Test

REMARKS:

Irrigation of 42.7 acres.