

STATE ENGINEER  
Salem, Oregon

LINN 4166  
Well Record

STATE WELL NO. 10/2W-17E(1)  
COUNTY Linn  
APPLICATION NO. GR-1858

Linn  
4166


OWNER: Tessa Watkins

MAILING  
ADDRESS:  
CITY AND  
STATE:

LOCATION OF WELL: Owner's No. 1

SW 1/4 NW 1/4 Sec. 17 T. 10 N. S. R. 2 E. W.M.

Bearing and distance from section or subdivision  
corner S 27° 30' E 24.6 chains  
(1624 feet) from the NW  
corner of section 17.

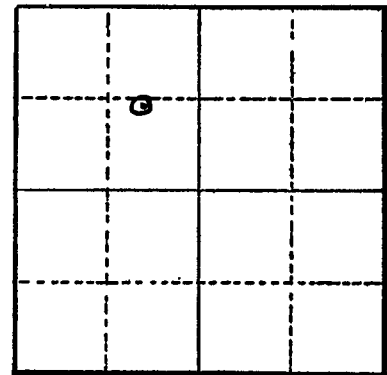

Section 17

Altitude at well

TYPE OF WELL: Irrig. Date Constructed June 1940

Depth drilled 21 Depth cased 21

CASING RECORD:

10" steel from 0-21 feet

9-23-2014

FINISH:

Ladonna,  
Please use this to  
replace page 1 of  
LINN 4166. I could  
not find the original  
log. Thanks.  
Karl Wozniak

AQUIFERS:

WATER LEVEL: 17 feet

PUMPING EQUIPMENT: Type  
Capacity G.P.M.

WELL TESTS:

Drawdown ft. after hours G.P.M.  
Drawdown ft. after hours G.P.M.

USE OF WATER Temp. °F. 19.

SOURCE OF INFORMATION Registration Statement GR-1858

DRILLER or DIGGER

ADDITIONAL DATA:

Log Water Level Measurements Chemical Analysis Aquifer Test

REMARKS: North Santiam River floodplain deposits.

LINN 4166

STATE ENGINEER  
Salem, Oregon

State Well No. 10/2W-17E(1)

County Linn

Application No. \_\_\_\_\_

### Water Level Record

OWNER: L OWNER'S NO. \_\_\_\_\_

Description of measuring point: Top of open 12" casing (south side) which is 1.0 below LSD.

Date	Water Level Feet <del>(above)</del> (below) Land Surface	Remarks	Date	Water Level Feet (above) (below) Land Surface	Remarks
<u>9-24-57</u>	<u>11.55</u>	<u>WSB</u>			

REMARKS: See hydrograph