

STATE ENGINEER
Salem, Oregon

Linn
4167

Well Record

STATE WELL NO. 10/2W-17M
COUNTY Linn
APPLICATION NO. GR-917

OWNER: Frank E. Gates


MAILING ADDRESS: Rt. 1, Box 415

LOCATION OF WELL: Owner's No. 1

CITY AND STATE: Albany, Oregon

NW 1/4 SW 1/4 Sec. 17 T. 10 N. S. R. 2 W., W.M.

Bearing and distance from section or subdivision corner S. 59° E. 8.5 chs. from NW cor. SW 1/4 Sec. 17

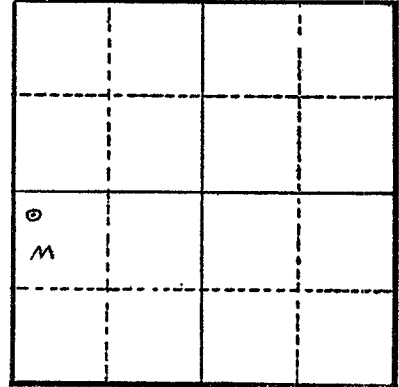

Section 17

Altitude at well 250 ft.

TYPE OF WELL: drilled Date Constructed Jan. 1947

Depth drilled 26 ft. Depth cased 26 ft.

CASING RECORD: 8 in. steel 0 to 26 ft.

FINISH: Slot perforations 14 to 26 ft.

AQUIFERS:

WATER LEVEL: 3 ft.

PUMPING EQUIPMENT: Type 3" centrifugal H.P. 20 elec.
Capacity 400 G.P.M.

WELL TESTS:
Drawdown 4 ft. after _____ hours 650 G.P.M.
Drawdown _____ ft. after _____ hours _____ G.P.M.

USE OF WATER irrigation Temp. _____ °F. _____, 19_____

SOURCE OF INFORMATION owner
DRILLER or DIGGER Marion West; Salem, Oregon

ADDITIONAL DATA:
Log _____ Water Level Measurements _____ Chemical Analysis _____ Aquifer Test _____

REMARKS: