

STATE ENGINEER
Salem, Oregon

Linn
4168

Well Record

STATE WELL NO. 10/2W-17N(1)
COUNTY Linn
APPLICATION NO. GR-1034

GR- 999

OWNER: M. C. and/or Pearl Helms


MAILING ADDRESS: Rt. 1

LOCATION OF WELL: Owner's No. #11

CITY AND STATE: Jefferson, Oregon

SW 1/4 SW 1/4 Sec. 17 T. 10 S., R. 2 W., W.M.

Bearing and distance from section or subdivision corner N87°30'E. 9.5 ch. from SW cor. Sec. 17.

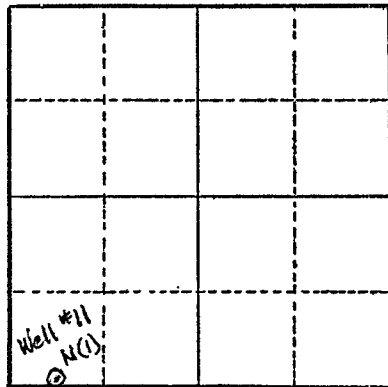

Section 17

Altitude at well 250 ft.

TYPE OF WELL: Drilled Date Constructed 1955

Depth drilled 36 ft. Depth cased 29 ft.

CASING RECORD:

8 inch from 7 to 36 ft. (pump set in pit)

FINISH:

Slot perforations from 24 to 36 ft.

AQUIFERS:

WATER LEVEL:

8 ft.

PUMPING EQUIPMENT: Type Cornell 2 1/2" Cent. H.P. 20

Capacity 350 G.P.M.

WELL TESTS:

Drawdown 10 ft. after 650 hours G.P.M.

Drawdown ft. after hours G.P.M.

USE OF WATER Irrigation Temp. °F., 19

SOURCE OF INFORMATION G.R. Record

DRILLER or DIGGER West, Marion

ADDITIONAL DATA:

Log N.A. Water Level Measurements Chemical Analysis Aquifer Test

REMARKS:

Irrigation of 42.7 acres.