

STATE ENGINEER
Salem, Oregon

LINN
4173

Well Record


STATE WELL NO. 10/2W-18A(1)
COUNTY Linn
APPLICATION NO. GR-592

OWNER: Dale & Lillian Eisenmann MAILING ADDRESS: Rt. 1

LOCATION OF WELL: Owner's No. 1 CITY AND STATE: Jefferson, Oregon

NE 1/4 NE 1/4 Sec. 18 T. 10 S., R. 2 W., W.M.

Bearing and distance from section or subdivision
corner N. 12° 40' W. 32.5 chs. from SE cor. NE 1/4
Sec. 18

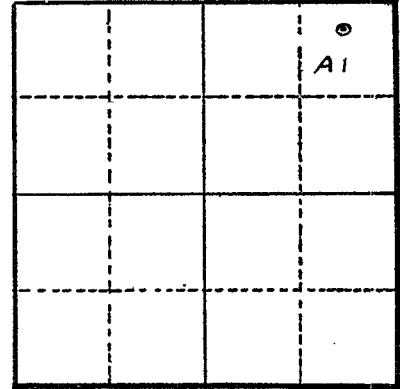

Section 18

Altitude at well 250 ft.

TYPE OF WELL: drilled Date Constructed 3/10/48

Depth drilled 28 ft. Depth cased 28 ft.

CASING RECORD: 8 inch

FINISH:

AQUIFERS:

WATER LEVEL: 8 ft.

PUMPING EQUIPMENT: Type Allis Chalmers centrifugal H.P. 10
Capacity 225 G.P.M.

WELL TESTS:
Drawdown 3 ft. after _____ hours 400 G.P.M.
Drawdown _____ ft. after _____ hours _____ G.P.M.

USE OF WATER irrigation 18 acres Temp. _____ °F., 19

SOURCE OF INFORMATION GR-592

DRILLER or DIGGER Marion West

ADDITIONAL DATA:

Log _____ Water Level Measurements _____ Chemical Analysis _____ Aquifer Test _____

REMARKS:

STATE ENGINEER
Salem, Oregon

State Well No. 10/W-18A (1)

County LINN

Application No. _____

Water Level Record

OWNER: _____ OWNER'S NO. _____

Description of measuring point: Top of 8" casing .60 feet above L.S.D
(south side of casing)

Date	Water Level Feet (above) (below) Land Surface	Remarks	Date	Water Level Feet (above) (below) Land Surface	Remarks
9-24-57	8.93	WSB			

REMARKS: See hydrograph