

STATE ENGINEER
Salem, Oregon

Linn
H174

Well Record

STATE WELL NO. 10/2W-18H(1)
COUNTY Linn
APPLICATION NO. GR-593

OWNER: Dale & Lillian Eisenmann


MAILING ADDRESS: Rt. 1

LOCATION OF WELL: Owner's No. _____

CITY AND STATE: Jefferson, Oregon

SE ¼ NE ¼ Sec. 18 T. 10 S., R. 2 W., W.M.

Bearing and distance from section or subdivision
corner N. 41° 45' W. 17.5 chs. from SE cor. NE ¼
Sec. 18

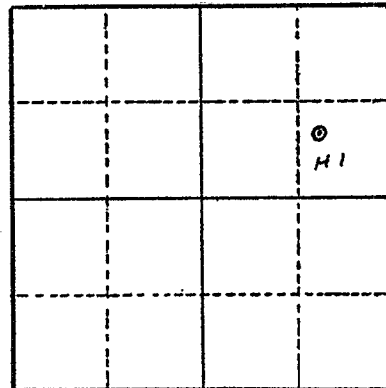

Section 18

Altitude at well 250 ft.

TYPE OF WELL: drilled Date Constructed 4/14/47

Depth drilled 25 ft. Depth cased 25 ft.

CASING RECORD: 8 inch

FINISH:

AQUIFERS:

WATER LEVEL: 4.74 ft. below (LSD) land surface 9-24-57

PUMPING EQUIPMENT: Type Fairbanks Morse centrifugal H.P. 15
Capacity 420 G.P.M.

WELL TESTS:
Drawdown 2 ft. after _____ hours 450 G.P.M.
Drawdown _____ ft. after _____ hours _____ G.P.M.

USE OF WATER Irrigation 44 acres Temp. _____ °F., 19 _____

SOURCE OF INFORMATION GR-593

DRILLER or DIGGER Marion West; Salem, Oregon

ADDITIONAL DATA:
Log _____ Water Level Measurements _____ Chemical Analysis _____ Aquifer Test _____

REMARKS:

STATE ENGINEER
Salem, Oregon

State Well No. 102w-18 H (1)

County Linn

Application No. _____

Water Level Record

OWNER: _____ OWNER'S NO. _____

Description of measuring point: Top of 8" casing which is 1.2 feet above LSD.

Date	Water Level Feet (above) (below) Land Surface	Remarks	Date	Water Level Feet (above) (below) Land Surface	Remarks
9-24-57	4.74	WSB			

REMARKS: See hydrograph