

STATE ENGINEER  
Salem, Oregon

Linn  
H175

# Well Record

STATE WELL NO. 10/2W-18J(1)  
COUNTY Linn  
APPLICATION NO. GR-594

OWNER: Dale & Lillian Eisenmann


MAILING ADDRESS: Rt. 1

LOCATION OF WELL: Owner's No. 3

CITY AND STATE: Jefferson, Oregon

NE 1/4 SE 1/4 Sec. 18 T. 10 N. S., R. 2 E. W., W.M.

Bearing and distance from section or subdivision corner S. 76° W. 20.75 chs. from NE cor. SE 1/4 Sec. 18

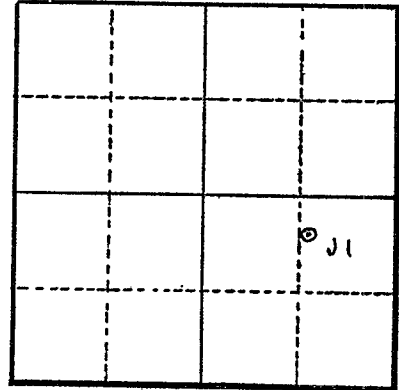

Section 18

Altitude at well 250 ft.

TYPE OF WELL: drilled Date Constructed 3/18/50

Depth drilled 28 ft. Depth cased 28 ft.

CASING RECORD: 8 inch

FINISH:

AQUIFERS:

WATER LEVEL: 10 ft.

PUMPING EQUIPMENT: Type Pacific centrifugal H.P. 10  
Capacity 325 G.P.M.

WELL TESTS:

Drawdown 3 ft. after \_\_\_\_\_ hours 400 G.P.M.

Drawdown \_\_\_\_\_ ft. after \_\_\_\_\_ hours \_\_\_\_\_ G.P.M.

USE OF WATER irrigation 24.5 acres Temp. \_\_\_\_\_ °F., 19

SOURCE OF INFORMATION GR-594

DRILLER or DIGGER Marion West; Salem, Oregon

ADDITIONAL DATA:

Log \_\_\_\_\_ Water Level Measurements \_\_\_\_\_ Chemical Analysis \_\_\_\_\_ Aquifer Test \_\_\_\_\_

REMARKS: