

STATE ENGINEER  
Salem, Oregon

Linn  
4176

# Well Record


STATE WELL NO. 10/2W-18J(2)  
COUNTY Linn  
APPLICATION NO. GR-595

OWNER: Dale & Lillian Eisenmann  
MAILING ADDRESS: Rt. 1

LOCATION OF WELL: Owner's No. 4  
CITY AND STATE: Jefferson, Oregon

NE 1/4 SE 1/4 Sec. 18 T. 10 N. S. R. 2 E. W., W.M.

Bearing and distance from section or subdivision  
corner S. 39° 15' W. 8.5 chs. from NE cor. SE 1/4  
Sec. 18

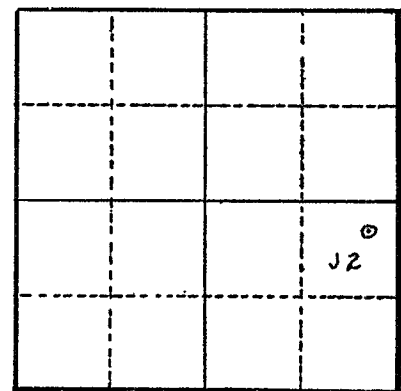

Altitude at well 250 ft.

TYPE OF WELL: drilled Date Constructed 7/12/55

Depth drilled 28 ft. Depth cased 28 ft.

Section 18

CASING RECORD: 6 inch

FINISH:

AQUIFERS:

WATER LEVEL: 10 ft.

PUMPING EQUIPMENT: Type Pacific centrifugal H.P. 5  
Capacity 175 G.P.M.

WELL TESTS:  
Drawdown 6 ft. after 250 hours G.P.M.  
Drawdown ft. after hours G.P.M.

USE OF WATER fire protec., industrial, irrigation 5 acres  
SOURCE OF INFORMATION GR-595 Temp. °F. 19

DRILLER or DIGGER  
ADDITIONAL DATA:  
Log Water Level Measurements Chemical Analysis Aquifer Test

REMARKS: