

STATE ENGINEER  
Salem, Oregon

Linn  
4178

# Well Record

STATE WELL NO. 10/2W-19M(1)  
COUNTY Linn  
APPLICATION NO. GR-1031

GR- 996

OWNER: M. C. and/or Pearl Helms


MAILING ADDRESS: Rt. 1

LOCATION OF WELL: Owner's No. #8

CITY AND STATE: Jefferson, Oregon

NW 1/4 SW 1/4 Sec. 19 T. 10 S., R. 2 W., W.M.

Bearing and distance from section or subdivision corner S75°50'E 14.25 ch. from W 1/4 cor. Sec. 19.

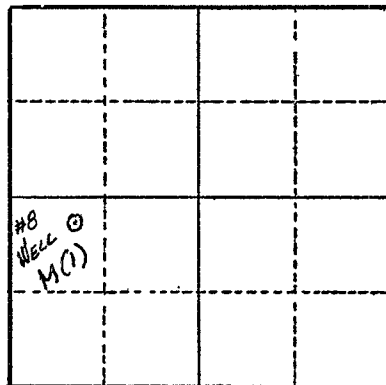

Section 19

Altitude at well 225 ft.

TYPE OF WELL: Drilled Date Constructed 1945

Depth drilled 28 ft. Depth cased 28 ft.

### CASING RECORD:

8 inch

### FINISH:

Slot perforations from 16 to 28 ft.

### AQUIFERS:

### WATER LEVEL:

6 ft.

PUMPING EQUIPMENT: Type F. M. 3" Cent. H.P. 15

Capacity 300 G.P.M.

### WELL TESTS:

Drawdown 4 ft. after          hours 650 G.P.M.

Drawdown          ft. after          hours          G.P.M.

USE OF WATER Irrigation Temp.          °F.         , 19        

SOURCE OF INFORMATION G.R. Record

DRILLER or DIGGER Marion West

### ADDITIONAL DATA:

Log N.A. Water Level Measurements          Chemical Analysis          Aquifer Test         

### REMARKS:

Irrigation of 24.4 acres.