

STATE ENGINEER
Salem, Oregon

Linn
H179

Well Record

STATE WELL NO. 10/2W-19M(2)
COUNTY Linn
APPLICATION NO. GR-1032

GR- 997

OWNER: M. C. and/or Pearl Helms


MAILING ADDRESS: Rt. 1

LOCATION OF WELL: Owner's No. #9

CITY AND STATE: Jefferson, Oregon

NW 1/4 SW 1/4 Sec. 19 T. 10 S., R. 2 W., W.M.

Bearing and distance from section or subdivision corner S27°E. 19.75 ch. from W¹/₄ cor. Sec. 19.

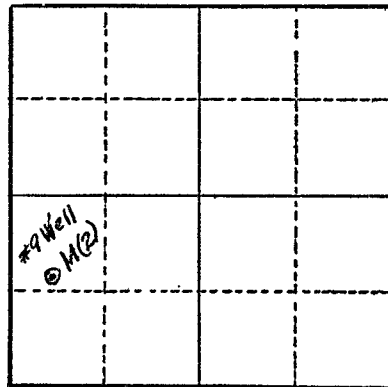

Section 19

Altitude at well 225 ft.

TYPE OF WELL: Drilled Date Constructed 1951

Depth drilled 21 ft. Depth cased 21 ft.

CASING RECORD:

8 inch

FINISH:

Slot perforations from 9 to 21 ft.

AQUIFERS:

WATER LEVEL:

6 ft.

PUMPING EQUIPMENT: Type F.M. 2" Cent. H.P. 10
Capacity 250 G.P.M.

WELL TESTS:

Drawdown 8 ft. after 300 hours G.P.M.
Drawdown ft. after hours G.P.M.

USE OF WATER Irrigation Temp. °F., 19

SOURCE OF INFORMATION G.R. Record

DRILLER or DIGGER Marion West

ADDITIONAL DATA:

Log N.A. Water Level Measurements Chemical Analysis Aquifer Test

REMARKS:

Irrigation of 12.3 acres.