

STATE ENGINEER
Salem, Oregon

Linn
4182

Well Record

STATE WELL NO. 10/2W-19P(1)
COUNTY Linn
APPLICATION NO. GR-297

OWNER: Noble D. Bradley

MAILING
ADDRESS:

Rt. 1, Box 205

LOCATION OF WELL: Owner's No.

CITY AND
STATE:


Jefferson, Oregon

SE $\frac{1}{4}$ SW $\frac{1}{4}$ Sec. 19 T. 10 N. S. R. 2 E. W. W.M.

Bearing and distance from section or subdivision

corner S. $67^{\circ} 20'$ W. 682.40 ft. and S. $86^{\circ} 35'$ W.

1250 ft. from SE cor. NW $\frac{1}{4}$ of SE $\frac{1}{4}$ Sec. 19

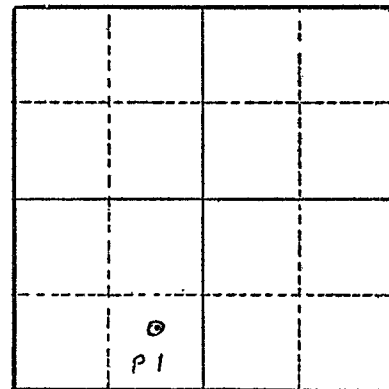

Altitude at well 230 ft. Interpolated

TYPE OF WELL: drilled Date Constructed 1942

Depth drilled 20 ft. Depth cased 20 ft.

Section 19

CASING RECORD: 6 - inch steel casing set from 0 to 20 ft.

FINISH: $\frac{1}{4}$ in. holes set from 12 to 20 ft.

AQUIFERS: Sand & gravel from 4 to 20 ft.

WATER LEVEL: 12 ft. below land surface

PUMPING EQUIPMENT: Type Allis Chalmers centrifugal H.P. 15
Capacity 650 G.P.M.

WELL TESTS:
Drawdown 6 ft. after hours pumping 650 G.P.M.
Drawdown ft. after hours G.P.M.

USE OF WATER Irrigation 70 acres Temp. $^{\circ}$ F. 19

SOURCE OF INFORMATION Reg. St. GR-297

DRILLER or DIGGER

ADDITIONAL DATA:

Log X Water Level Measurements Chemical Analysis Aquifer Test

REMARKS: Log: Dirt 0 to 4 ft.
Silt & sand 4 to 10 ft.
Gravel 10 to 20 ft.