

STATE ENGINEER  
Salem, Oregon

*Linn High*  
**Well Record**

STATE WELL NO. 10/2W-19E  
COUNTY Linn  
APPLICATION NO. GR-3740

OWNER: Harvey Mitchell


MAILING ADDRESS: Route 1

LOCATION OF WELL: Owner's No. 6

CITY AND STATE: Jefferson, Oregon

SW 1/4 NW 1/4 Sec. 19 T. 10 N. S., R. 2 E. W., W.M.

Bearing and distance from section or subdivision corner 563 feet North 8° East of W/4 Corner, Section 19

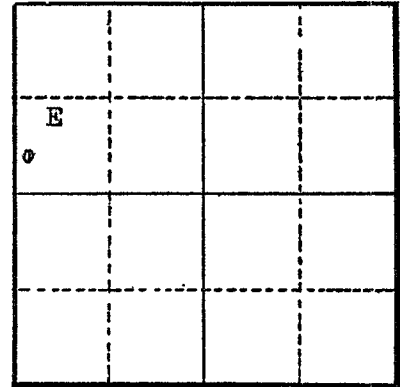

Altitude at well 226 feet

TYPE OF WELL: Drilled Date Constructed 1948

Depth drilled 21 feet Depth cased \_\_\_\_\_

Section 19

CASING RECORD:

6-inch casing

FINISH:

AQUIFERS:

WATER LEVEL:  
10 feet

PUMPING EQUIPMENT: Type Pacific H.P. \_\_\_\_\_  
Capacity 100 G.P.M.

WELL TESTS:  
Drawdown 6 ft. after \_\_\_\_\_ hours 100 G.P.M.  
Drawdown \_\_\_\_\_ ft. after \_\_\_\_\_ hours \_\_\_\_\_ G.P.M.

USE OF WATER Industrial Temp. \_\_\_\_\_ °F., 19 \_\_\_\_\_

SOURCE OF INFORMATION GR-4147

DRILLER or DIGGER Bill Hamilton, Albany

ADDITIONAL DATA:  
Log (NA) Water Level Measurements \_\_\_\_\_ Chemical Analysis \_\_\_\_\_ Aquifer Test \_\_\_\_\_

REMARKS: