

STATE ENGINEER
Salem, Oregon

Linn
H188

Well Record

STATE WELL NO. 10/2W-19F(1)
COUNTY Linn
APPLICATION NO. GR-1030

GR- 995

OWNER: M. C. and/or Pearl Helms

MAILING ADDRESS: Rt. 1


LOCATION OF WELL: Owner's No. #7

CITY AND STATE: Jefferson, Oregon

SE 1/4 NW 1/4 Sec. 19 T. 10 S., R. 2 W., W.M.

Bearing and distance from section or subdivision

corner N. 81° 35' E. 34.75 ch. from W 1/4 cor. Sec. 19.

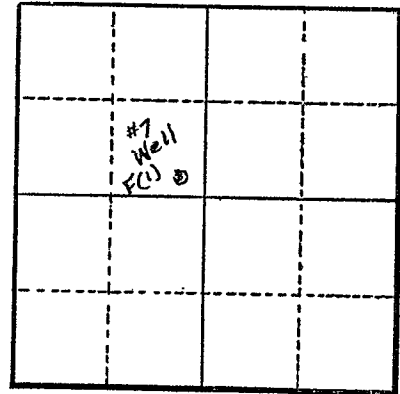

Section 19

Altitude at well 225 ft.

TYPE OF WELL: Drilled Date Constructed 1942

Depth drilled 21 ft. Depth cased 21 ft.

CASING RECORD:

8 inch

FINISH:

Slot perforations from 9 to 21 ft.

AQUIFERS:

WATER LEVEL:

6 ft.

PUMPING EQUIPMENT: Type F. M. 3" Cent.

H.P. 20

Capacity 400 G.P.M.

WELL TESTS:

Drawdown 4 ft. after hours 650 G.P.M.

Drawdown ft. after hours G.P.M.

USE OF WATER Irrigation Temp. °F., 19

SOURCE OF INFORMATION G.R. Record

DRILLER or DIGGER Marion West

ADDITIONAL DATA:

Log N.A. Water Level Measurements Chemical Analysis Aquifer Test

REMARKS:

Irrigations of 40.6 acres.