

Linn
H190

Well Record

OWNER: Orville E. and Ester Sheffield

MAILING ADDRESS: Route 1


LOCATION OF WELL: Owner's No.

CITY AND STATE: Jefferson, Oregon

SE 1/4 NE 1/4 Sec. 19 T. 10 N. S. R. 2 E. W., W.M.

Bearing and distance from section or subdivision

corner N. 52° 30' W. 15.8 chains from the
S.E. corner of the NE 1/4 of Section 19

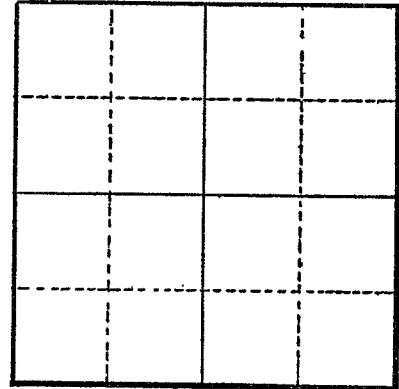

Section 22

Altitude at well

TYPE OF WELL: drilled Date Constructed 1945

Depth drilled 22 Depth cased 22

CASING RECORD:

12 inch

FINISH:

Slot perforations from 18 to 22

AQUIFERS:

WATER LEVEL:

7 feet

PUMPING EQUIPMENT: Type Fairbanks Morse centrifugal H.P. 15
Capacity 350 G.P.M.

WELL TESTS:

Drawdown ft. after hours G.P.M.

Drawdown ft. after hours G.P.M.

USE OF WATER Irrigation Temp. °F. 19

SOURCE OF INFORMATION GR-2996

DRILLER or DIGGER

ADDITIONAL DATA:

Log Water Level Measurements Chemical Analysis Aquifer Test

REMARKS: