

STATE ENGINEER  
Salem, Oregon

Linn  
4192

# Well Record

GR- 989

STATE WELL NO. 10/2W-19K(1)  
COUNTY Linn  
APPLICATION NO. GR-1024

OWNER: M. G. and/or Pearl Helms

MAILING ADDRESS: Rt. 1


LOCATION OF WELL: Owner's No. #1

CITY AND STATE: Jefferson, Oregon

NW 1/4 SE 1/4 Sec. 19 T. 10 S., R. 2 W., W.M.

Bearing and distance from section or subdivision

corner S35°30'E. 22.75 ch. from NW cor. SE 1/4 of  
Section 19. (Center of Section)

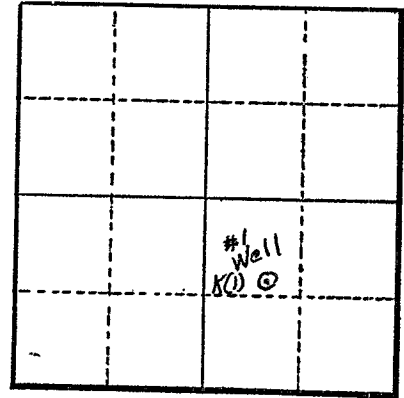

Section 19

Altitude at well 225 ft.

TYPE OF WELL: Drilled Date Constructed 1942

Depth drilled 21 ft. Depth cased 21 ft.

### CASING RECORD:

8 inch

### FINISH:

Slot perforations from 11 to 21 ft.

### AQUIFERS:

### WATER LEVEL:

2 ft.

PUMPING EQUIPMENT: Type F. M. 2" Cent. H.P. 10  
Capacity 250 G.P.M.

### WELL TESTS:

Drawdown 1 ft. after \_\_\_\_\_ hours 1000 G.P.M.

Drawdown \_\_\_\_\_ ft. after \_\_\_\_\_ hours \_\_\_\_\_ G.P.M.

USE OF WATER Industrial Temp. \_\_\_\_\_ °F. \_\_\_\_\_, 19\_\_\_\_

SOURCE OF INFORMATION G.R. Record

DRILLER or DIGGER Marion West

### ADDITIONAL DATA:

Log N.A. Water Level Measurements \_\_\_\_\_ Chemical Analysis \_\_\_\_\_ Aquifer Test \_\_\_\_\_

### REMARKS: