

STATE ENGINEER  
Salem, Oregon

Linn  
4193

# Well Record

STATE WELL NO. 10/2W-19K(2)  
COUNTY Linn  
APPLICATION NO. GR-1025

GR- 990

OWNER: M. C. and/or Pearl Helms

MAILING ADDRESS: Rt. 1


LOCATION OF WELL: Owner's No. #2

CITY AND STATE: Jefferson, Oregon

NW 1/4 SE 1/4 Sec. 19 T. 10 S., R. 2 W., W.M.

Bearing and distance from section or subdivision

corner S29°E. 21.5 ch. from NW cor. of SE 1/4 (Center)  
of Section 19.

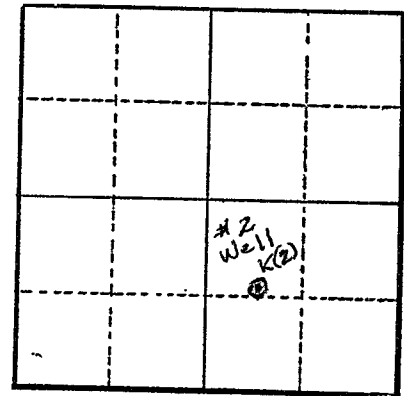

Section 19

Altitude at well 225 ft.

TYPE OF WELL: Drilled Date Constructed 1943

Depth drilled 30 ft. Depth cased 30 ft.

### CASING RECORD:

8 inch

### FINISH:

Slot perforations from 18 to 30 ft.

### AQUIFERS:

### WATER LEVEL:

10 ft.

PUMPING EQUIPMENT: Type Pacific 2" Cent.

H.P. 10

Capacity 250 G.P.M.

### WELL TESTS:

Drawdown 3 ft. after 600 hours          G.P.M.

Drawdown          ft. after          hours          G.P.M.

USE OF WATER Irrigation & fire protect. Temp.          °F.         , 19        

SOURCE OF INFORMATION G.R. Record

DRILLER or DIGGER Marion West

### ADDITIONAL DATA:

Log N.A. Water Level Measurements          Chemical Analysis          Aquifer Test         

### REMARKS:

Irrigation of 2.2 acres.