

STATE ENGINEER
Salem, Oregon

Linn
4195

Well Record

STATE WELL NO. 10/2W-19K(4)
COUNTY Linn
APPLICATION NO. GR-1027

GR- 992

OWNER: M. G. and/or Pearl Helms

MAILING ADDRESS: Rt. 1


LOCATION OF WELL: Owner's No. #4

CITY AND STATE: Jefferson, Oregon

NW 1/4 SE 1/4 Sec. 19 T. 10 S. R. 2 W., W.M.

Bearing and distance from section or subdivision

corner S58°15'E. 2.25 ch. from Center Sec. 19.

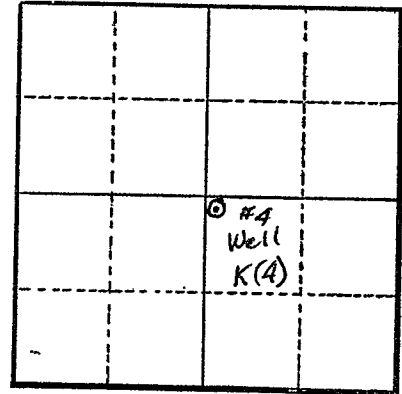

Section 19

Altitude at well 225 ft.

TYPE OF WELL: Drilled Date Constructed 1951

Depth drilled 26 ft. Depth cased 26 ft.

CASING RECORD:

8 inch

FINISH:

Slot perforations from 14 to 26 ft.

AQUIFERS:

WATER LEVEL:

7 ft.

PUMPING EQUIPMENT: Type F. M. 2" Cent.

H.P. 7 1/2

Capacity 200 G.P.M.

WELL TESTS:

Drawdown 2 ft. after _____ hours 650 G.P.M.

Drawdown _____ ft. after _____ hours _____ G.P.M.

USE OF WATER Irrigation Temp. _____ °F. _____, 19____

SOURCE OF INFORMATION G.R. Record

DRILLER or DIGGER Marion West

ADDITIONAL DATA:

Log N.A. Water Level Measurements _____ Chemical Analysis _____ Aquifer Test _____

REMARKS:

Irrigation of 5.7 acres.