

STATE ENGINEER
Salem, Oregon

Well Record

STATE WELL NO. 10/2W-19B(1)
COUNTY Linn
APPLICATION NO. GR-596

OWNER: Dale & Lillian Eisenmann

MAILING

ADDRESS: Rt. 1

LOCATION OF WELL: Owner's No. 5


CITY AND

STATE: Jefferson, Oregon

NE $\frac{1}{4}$ NW $\frac{1}{4}$ Sec. 19 T. 10 N. S. R. 2 E. W.M.

Bearing and distance from section or subdivision

corner S. $45^{\circ} 40'$ W. 64.5 chs. from NE cor. SE $\frac{1}{4}$ Sec. 18

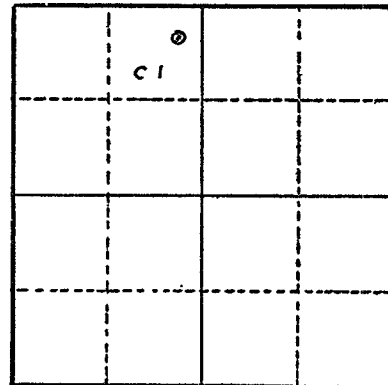

Section 19

Altitude at well 250 ft.

TYPE OF WELL: drilled Date Constructed 11/15/54

Depth drilled 28 ft. Depth cased 28 ft.

CASING RECORD: 8 inch

FINISH:

AQUIFERS:

WATER LEVEL: 6 ft.

PUMPING EQUIPMENT: Type Pacific centrifugal H.P. 20
Capacity 525 G.P.M.

WELL TESTS:

Drawdown 2 ft. after 700 hours G.P.M.

Drawdown ft. after hours G.P.M.

USE OF WATER irrigation 47 acres Temp. $^{\circ}$ F. 19

SOURCE OF INFORMATION GR-596

DRILLER or DIGGER Marion West; Salem, Oregon

ADDITIONAL DATA:

Log Water Level Measurements Chemical Analysis Aquifer Test

REMARKS: