

STATE ENGINEER
Salem, Oregon

Linn
4206

Well Record

STATE WELL NO. 10/2W-190(1)
COUNTY Linn
APPLICATION NO. GR-297

OWNER: Noble D. Bradley

MAILING
ADDRESS:

Rt. 1, Box 205


LOCATION OF WELL: Owner's No. 1

CITY AND
STATE:

Jefferson, Oregon

SW $\frac{1}{4}$ SE $\frac{1}{4}$ Sec. 19 T. 10 S. R. 2 W., W.M.

Bearing and distance from section or subdivision
corner S. $67^{\circ}20'$ W. 682.40 ft. from SE cor. NW of
SE quarter Sec. 19

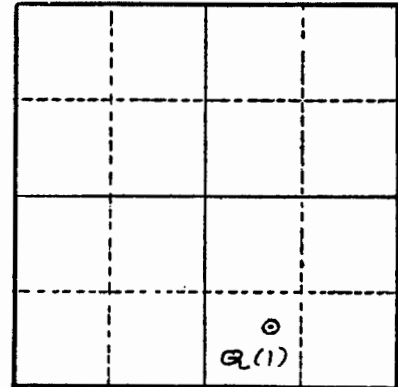

Altitude at well 230 ft. Interpolated

TYPE OF WELL: drilled Date Constructed 1940

Depth drilled 20 ft. Depth cased 20 ft.

Section 19

CASING RECORD: 8 - inch steel casing set from 0 to 20 ft.

FINISH: $\frac{1}{4}$ in. perforations set from 12 to 20 ft.

AQUIFERS: Sand & gravel - from 4 to 20 ft.

WATER LEVEL: 6 ft. below land surface

PUMPING EQUIPMENT: Type Allis Chalmers centrifugal H.P. 15
Capacity 650 G.P.M.

WELL TESTS:
Drawdown 12 ft. after hours pumping 650 G.P.M.
Drawdown ft. after hours G.P.M.

USE OF WATER Irrigation Temp. °F., 19

SOURCE OF INFORMATION G. R. 297

DRILLER or DIGGER

ADDITIONAL DATA:

Log ☒ Water Level Measurements Chemical Analysis Aquifer Test

REMARKS:

STATE ENGINEER
Salem, Oregon

State Well No. 10/2W-19Q(1)
County Linn
Application No. GR-297

Owner: Noble D. Bradley Owner's No. 1

[illegible]