

STATE ENGINEER
Salem, Oregon

Linn
4207

Well Record

STATE WELL NO. 10/2W-19R
COUNTY Linn
APPLICATION NO. GR-3216

OWNER: Ellis and Blanch Hamby

MAILING ADDRESS: Route 1, Box 277A

LOCATION OF WELL: Owner's No. 2


CITY AND STATE: Jefferson, Oregon

SE 1/4 SE 1/4 Sec. 19 T. 10 N. S., R. 2 E. W., W.M.

Bearing and distance from section or subdivision

corner N. 45° 15' W. 15 chains from S.E.

corner of Section 19

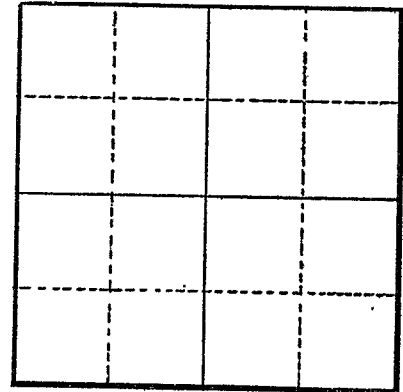

Section

Altitude at well

TYPE OF WELL: drilled Date Constructed 1943

Depth drilled 30 Depth cased 30

CASING RECORD:

12 inch

FINISH:

Slot perforations from 20 to 30

AQUIFERS:

WATER LEVEL:

8 feet

PUMPING EQUIPMENT: Type Centrifugal H.P. 20
Capacity 400 G.P.M.

WELL TESTS:

Drawdown ft. after hours G.P.M.

Drawdown ft. after hours G.P.M.

USE OF WATER Irrigation Temp. °F., 19

SOURCE OF INFORMATION GR-2993

DRILLER or DIGGER Marion West, Salem, Oregon

ADDITIONAL DATA:

Log Water Level Measurements Chemical Analysis Aquifer Test

REMARKS: