

STATE ENGINEER
Salem, Oregon

Linn
4219

Well Record


STATE WELL NO. 10/2W-20D
COUNTY Linn
APPLICATION NO. GR-2392

OWNER: R. P. Richardson MAILING ADDRESS: Rt. 2, Box 385

LOCATION OF WELL: Owner's No. #2 CITY AND STATE: Albany, Oregon

NW 1/4 NW 1/4 Sec. 20 T. 10S, R. 2 W., W.M.

Bearing and distance from section or subdivision
corner 3 miles SE of Jefferson, Oregon, 924' S. & 957' E.

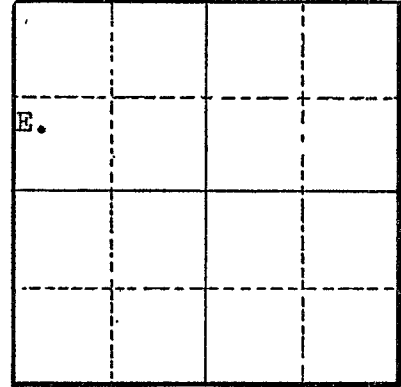

Section

Altitude at well

TYPE OF WELL: Drilled Date Constructed 1955

Depth drilled 30 Depth cased 30

CASING RECORD:

12-inch

FINISH:

Slot perforations from 20 to 30

AQUIFERS:

WATER LEVEL:

12-feet

PUMPING EQUIPMENT: Type Pacific 2 1/2" Centrifugal H.P. 20
Capacity 450 G.P.M.

WELL TESTS:

Drawdown 15 ft. after 1 hour Pumping 600 G.P.M.

Drawdown ft. after hours G.P.M.

USE OF WATER Irrigation Temp. °F. 19

SOURCE OF INFORMATION GR-2273

DRILLER or DIGGER Bill Hamilton Drilling Co., 838 E. Third Ave., Albany, Oregon

ADDITIONAL DATA:

Log Water Level Measurements Chemical Analysis Aquifer Test

REMARKS: