

STATE ENGINEER
Salem, Oregon

Linn
4221

Well Record

STATE WELL NO. 10/2W-20E
COUNTY LINN
APPLICATION NO. GR-2391

OWNER: R. P. Richardson


MAILING ADDRESS: Rt. 2, Box 385

LOCATION OF WELL: Owner's No. #1

CITY AND STATE: Albany, Oregon

SW 1/4 NW 1/4 Sec. 20 T. 10 N. S. R. 2 W., W.M.

Bearing and distance from section or subdivision
corner 3 miles SE of Jefferson, Oregon, 1940' S & 957' E.

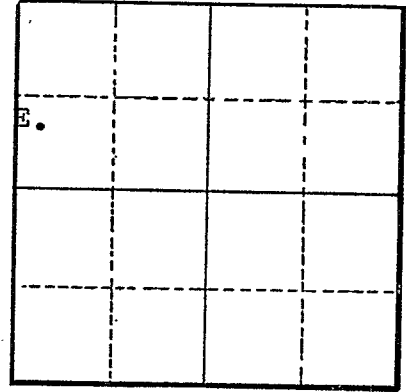

Altitude at well

TYPE OF WELL: Drilled Date Constructed 1950

Depth drilled 30 Depth cased 30

Section

CASING RECORD:

12-inch

FINISH:

Slot perforations from 20 to 30

AQUIFERS:

WATER LEVEL:

15-feet

PUMPING EQUIPMENT: Type Pacific 3 1/2" Centrifugal H.P. 20
Capacity 450 G.P.M.

WELL TESTS:

Drawdown 19 ft. after Pumping 600 G.P.M.
Drawdown ft. after hours G.P.M.

USE OF WATER Irrigation Temp. °F., 19

SOURCE OF INFORMATION GR-2272

DRILLER or DIGGER Bill Hamilton Drilling Co., 838 E. Third Ave., Albany, Oregon

ADDITIONAL DATA:

Log Water Level Measurements Chemical Analysis Aquifer Test

REMARKS: